

EXISTING HOME

VERIFY ALL DIMENSIONS
NO AS-BUILT INT. DIMENSIONS


CLG HT 8' TYP @ DROPPED CLG

1
A-2


AS-BUILT - ENTRY LEVEL @ STUDIO - FLOOR PLAN
SCALE 1/4"=1'-0" VERIFY DIMENSIONS IN FIELD




NOT FOR CONSTRUCTION

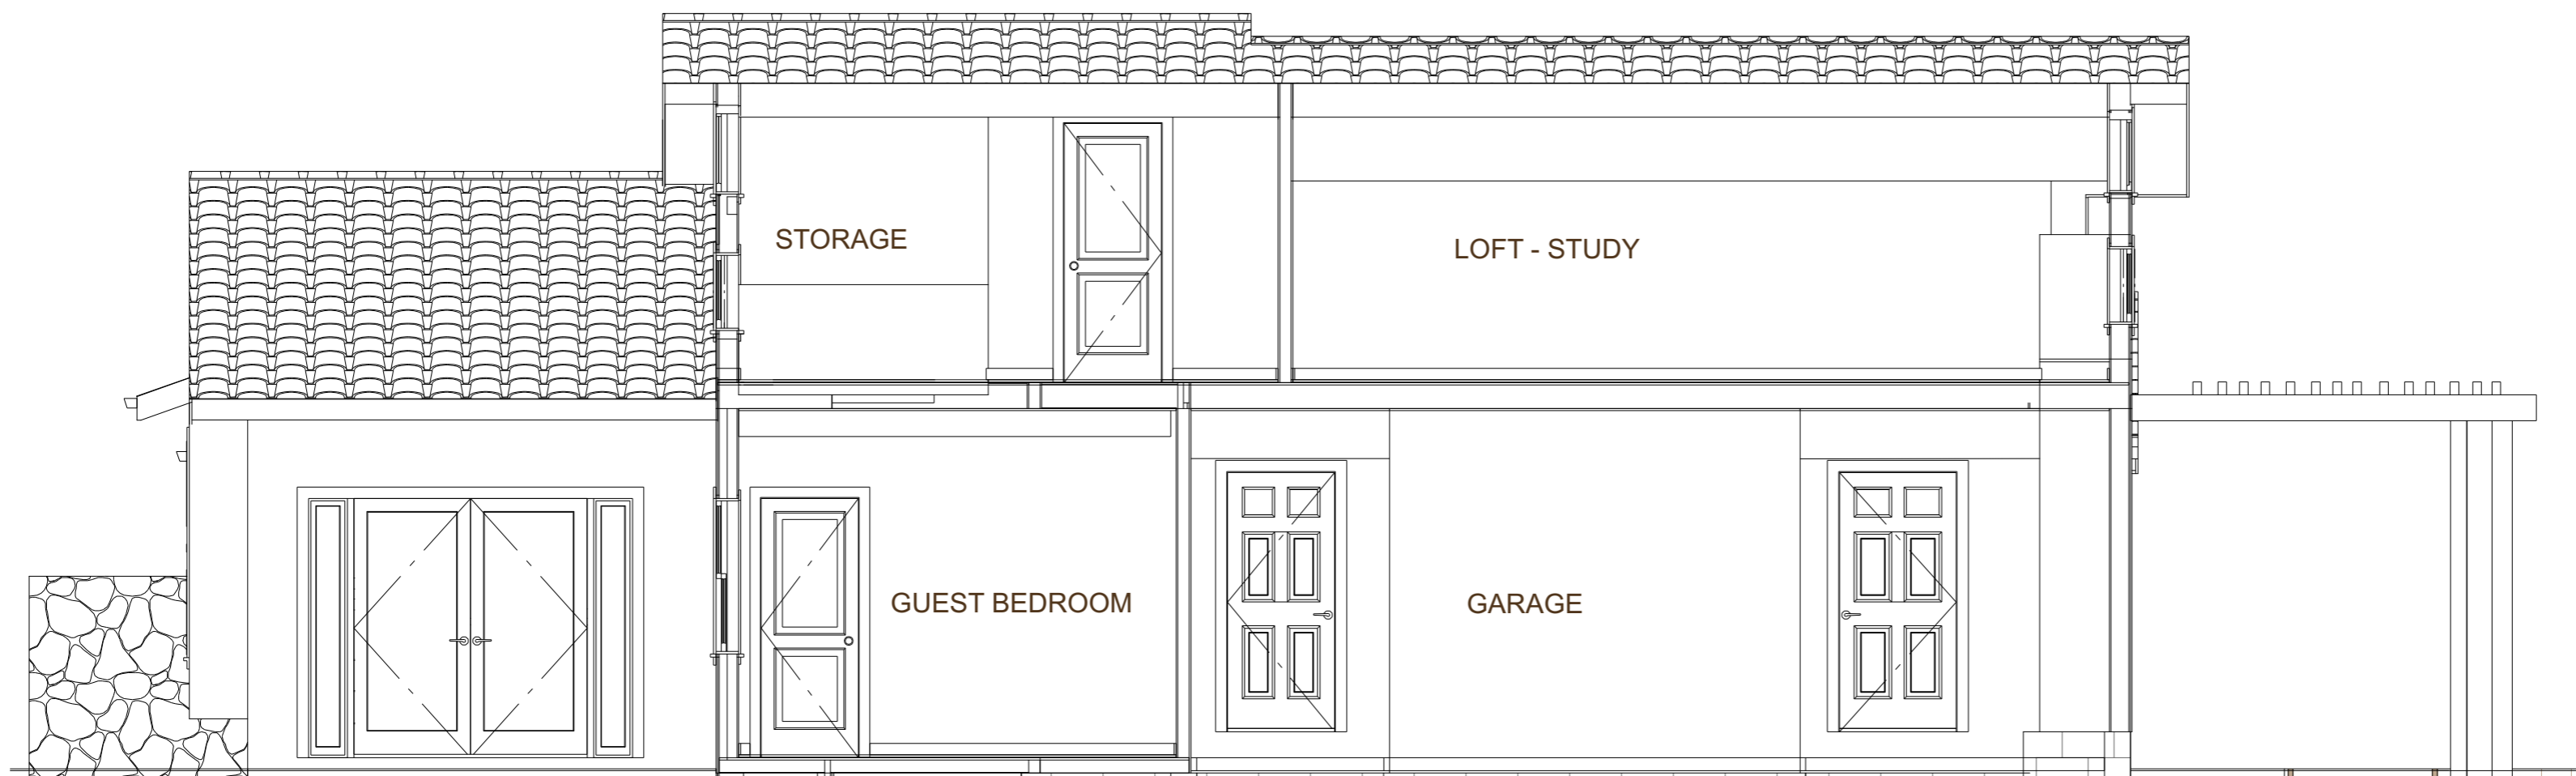


1 AS-BUILT - BUILDING SECTION @ LOFT & GARAGE
 A-3 SCALE 1/4"=1'-0" V.D.I.F.

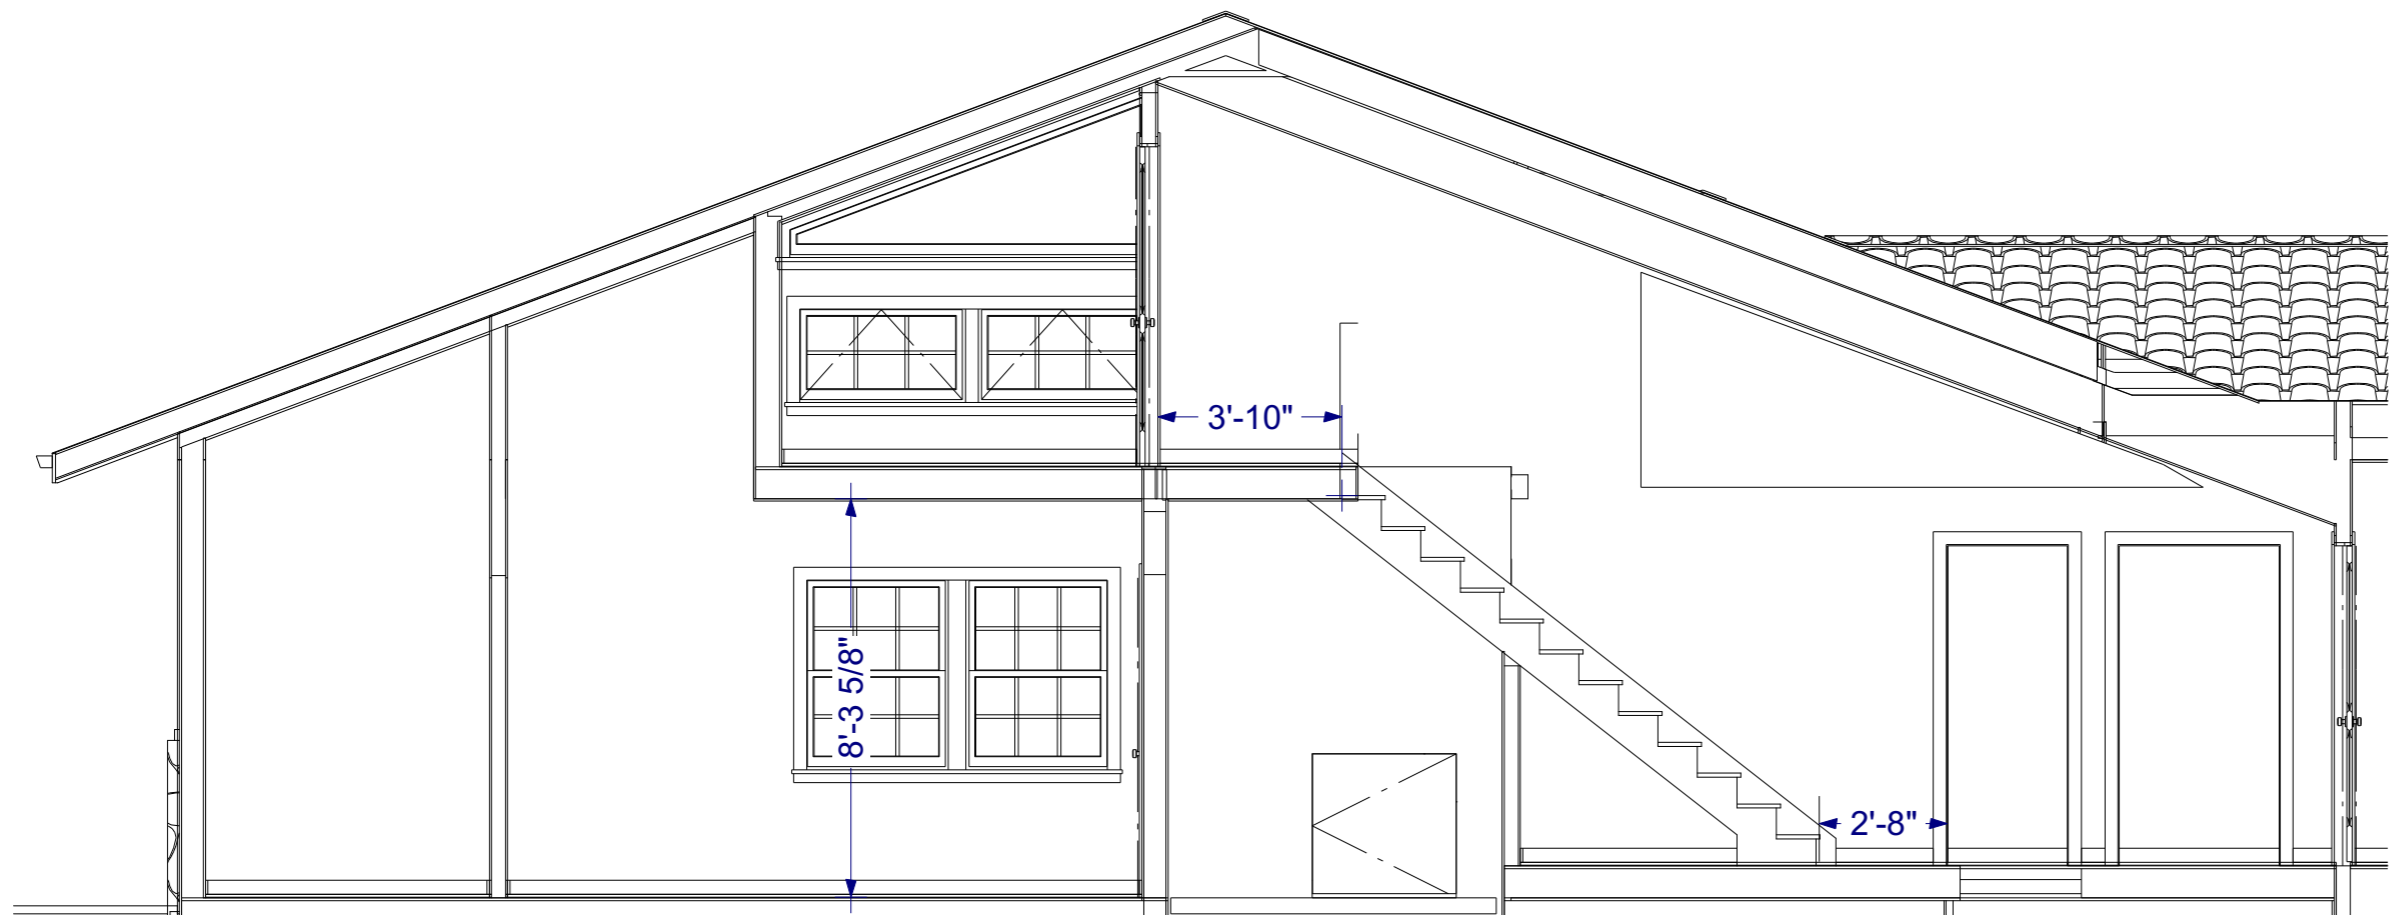

2 AS-BUILT - SECTION @ GARAGE - STUDIO & LOFT
 A-3 SCALE 1/4"=1'-0" VERIFY DIMENSIONS IN FIELD

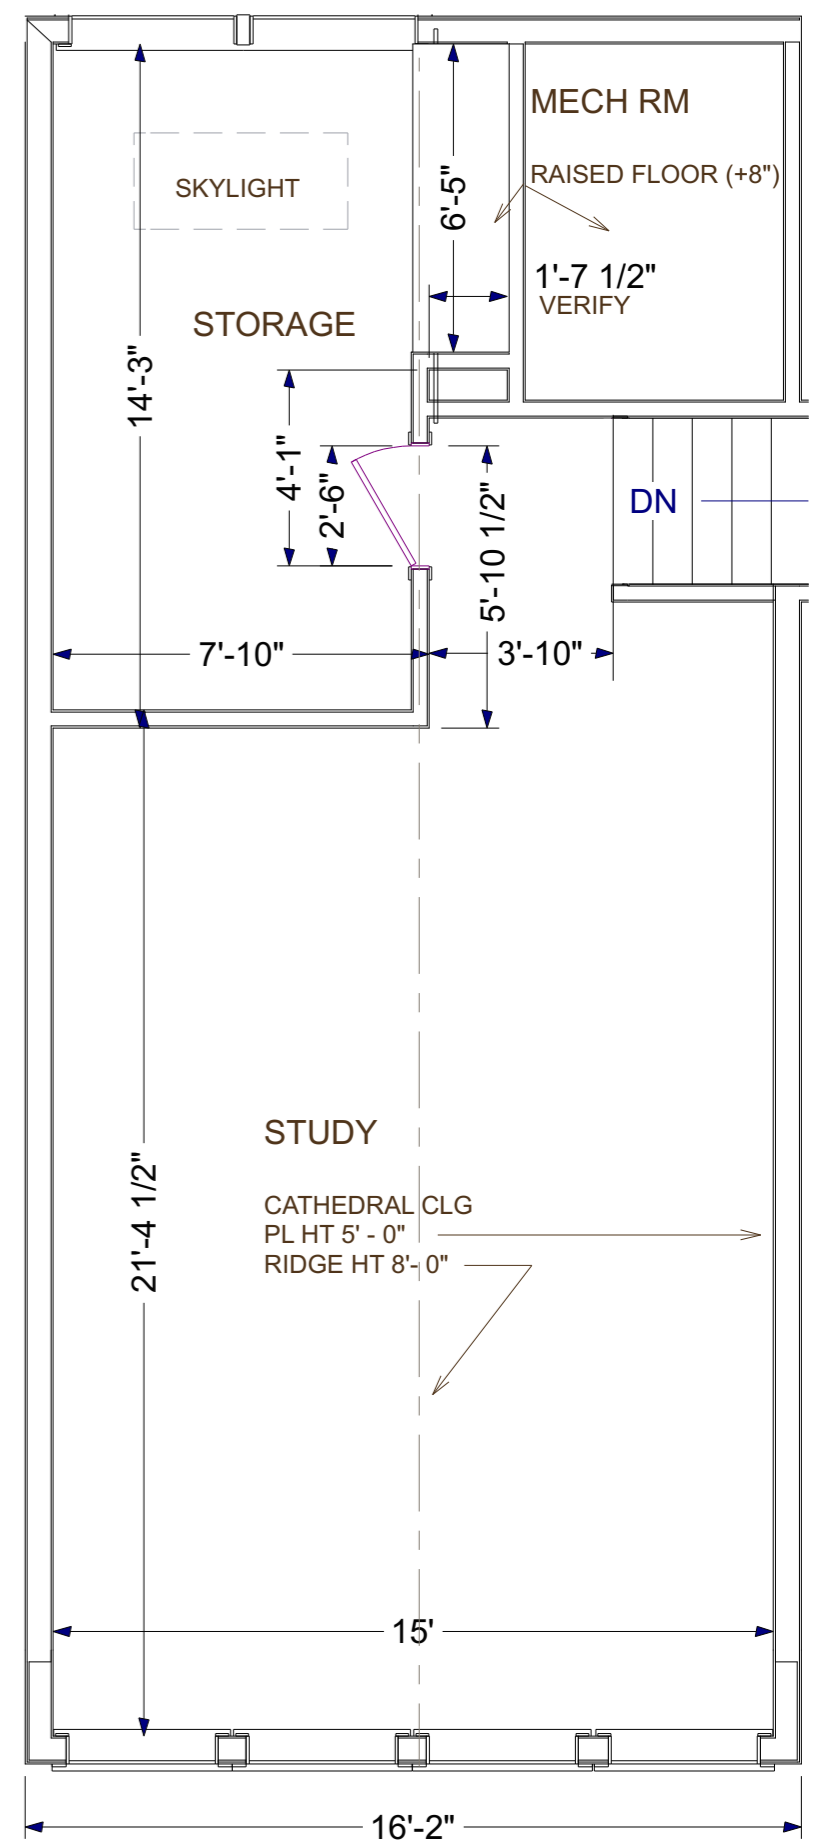


1 AS-BUILT - UPPER LEVEL - FLOOR PLAN
 A-3 SCALE 1/4"=1'-0" VERIFY DIMENSIONS IN FIELD

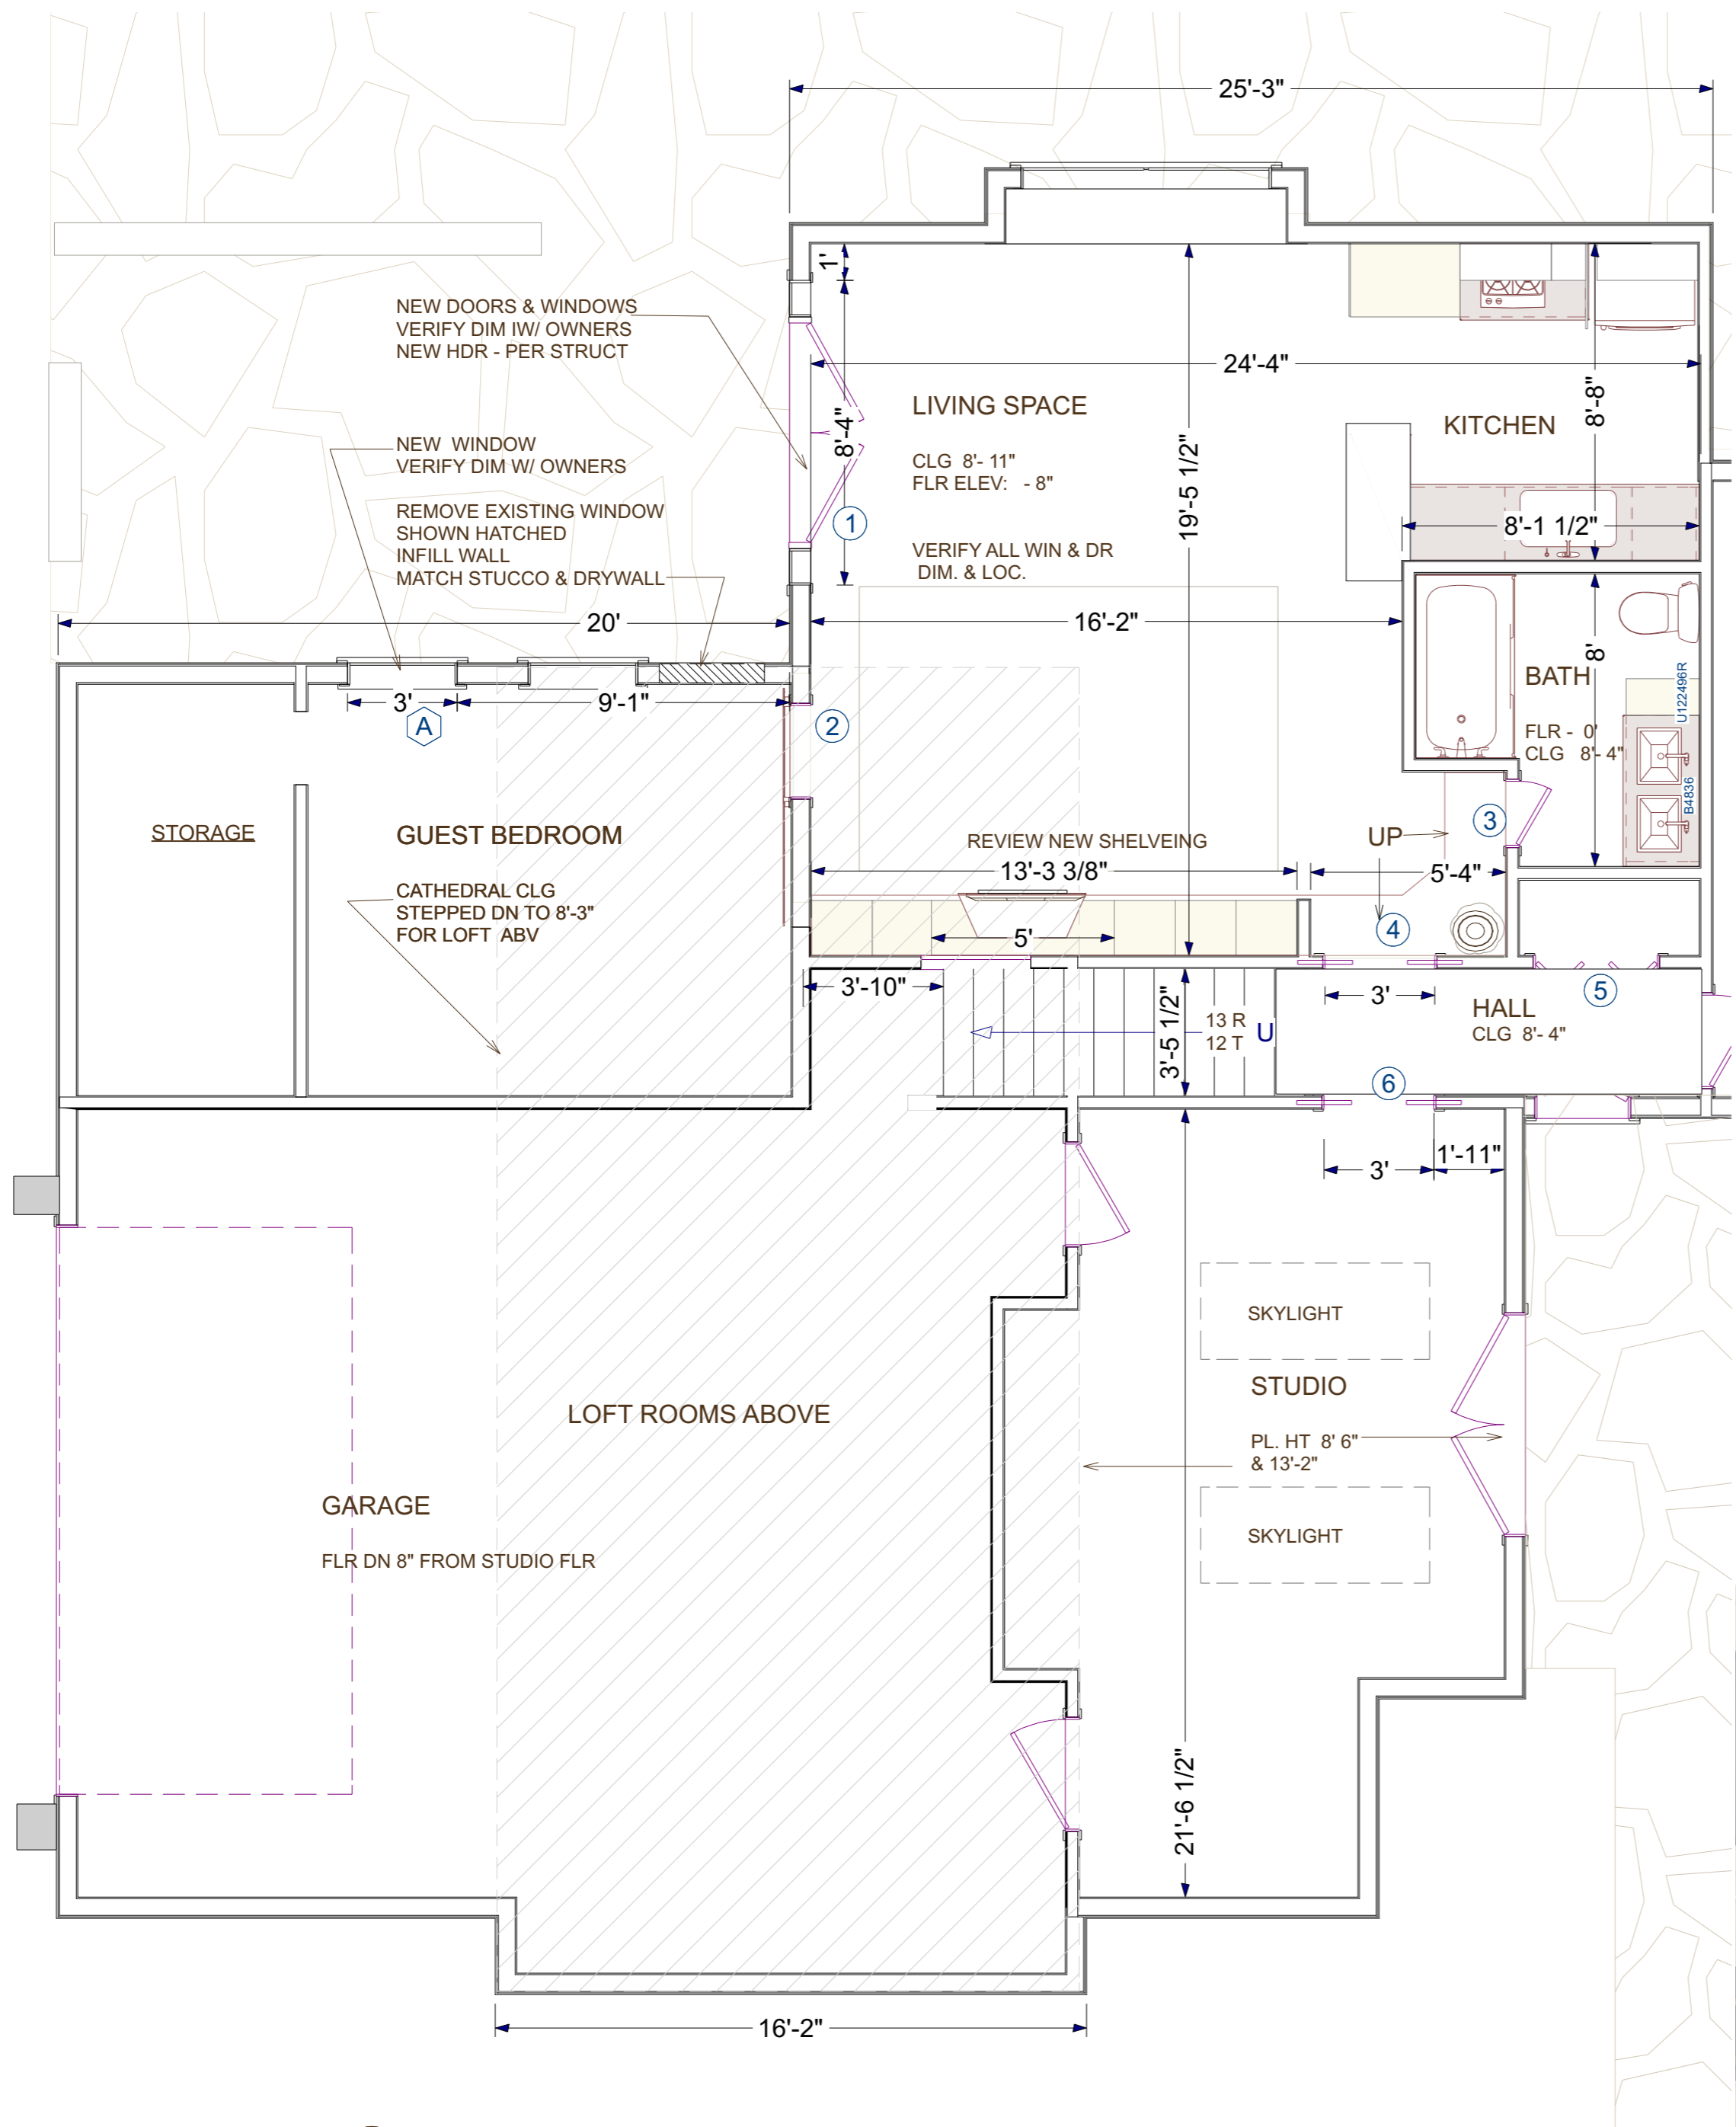

1 REMODEL - ENTRY LEVEL @ STUDIO - FLOOR PLAN
A-5 SCALE 1/4"=1'-0" V.D.I.F.

BUILD OUT EXIST COL.
(PHASE 2)


2 STUDIO - LIVING AREA
A-5 RENDER VIEWS

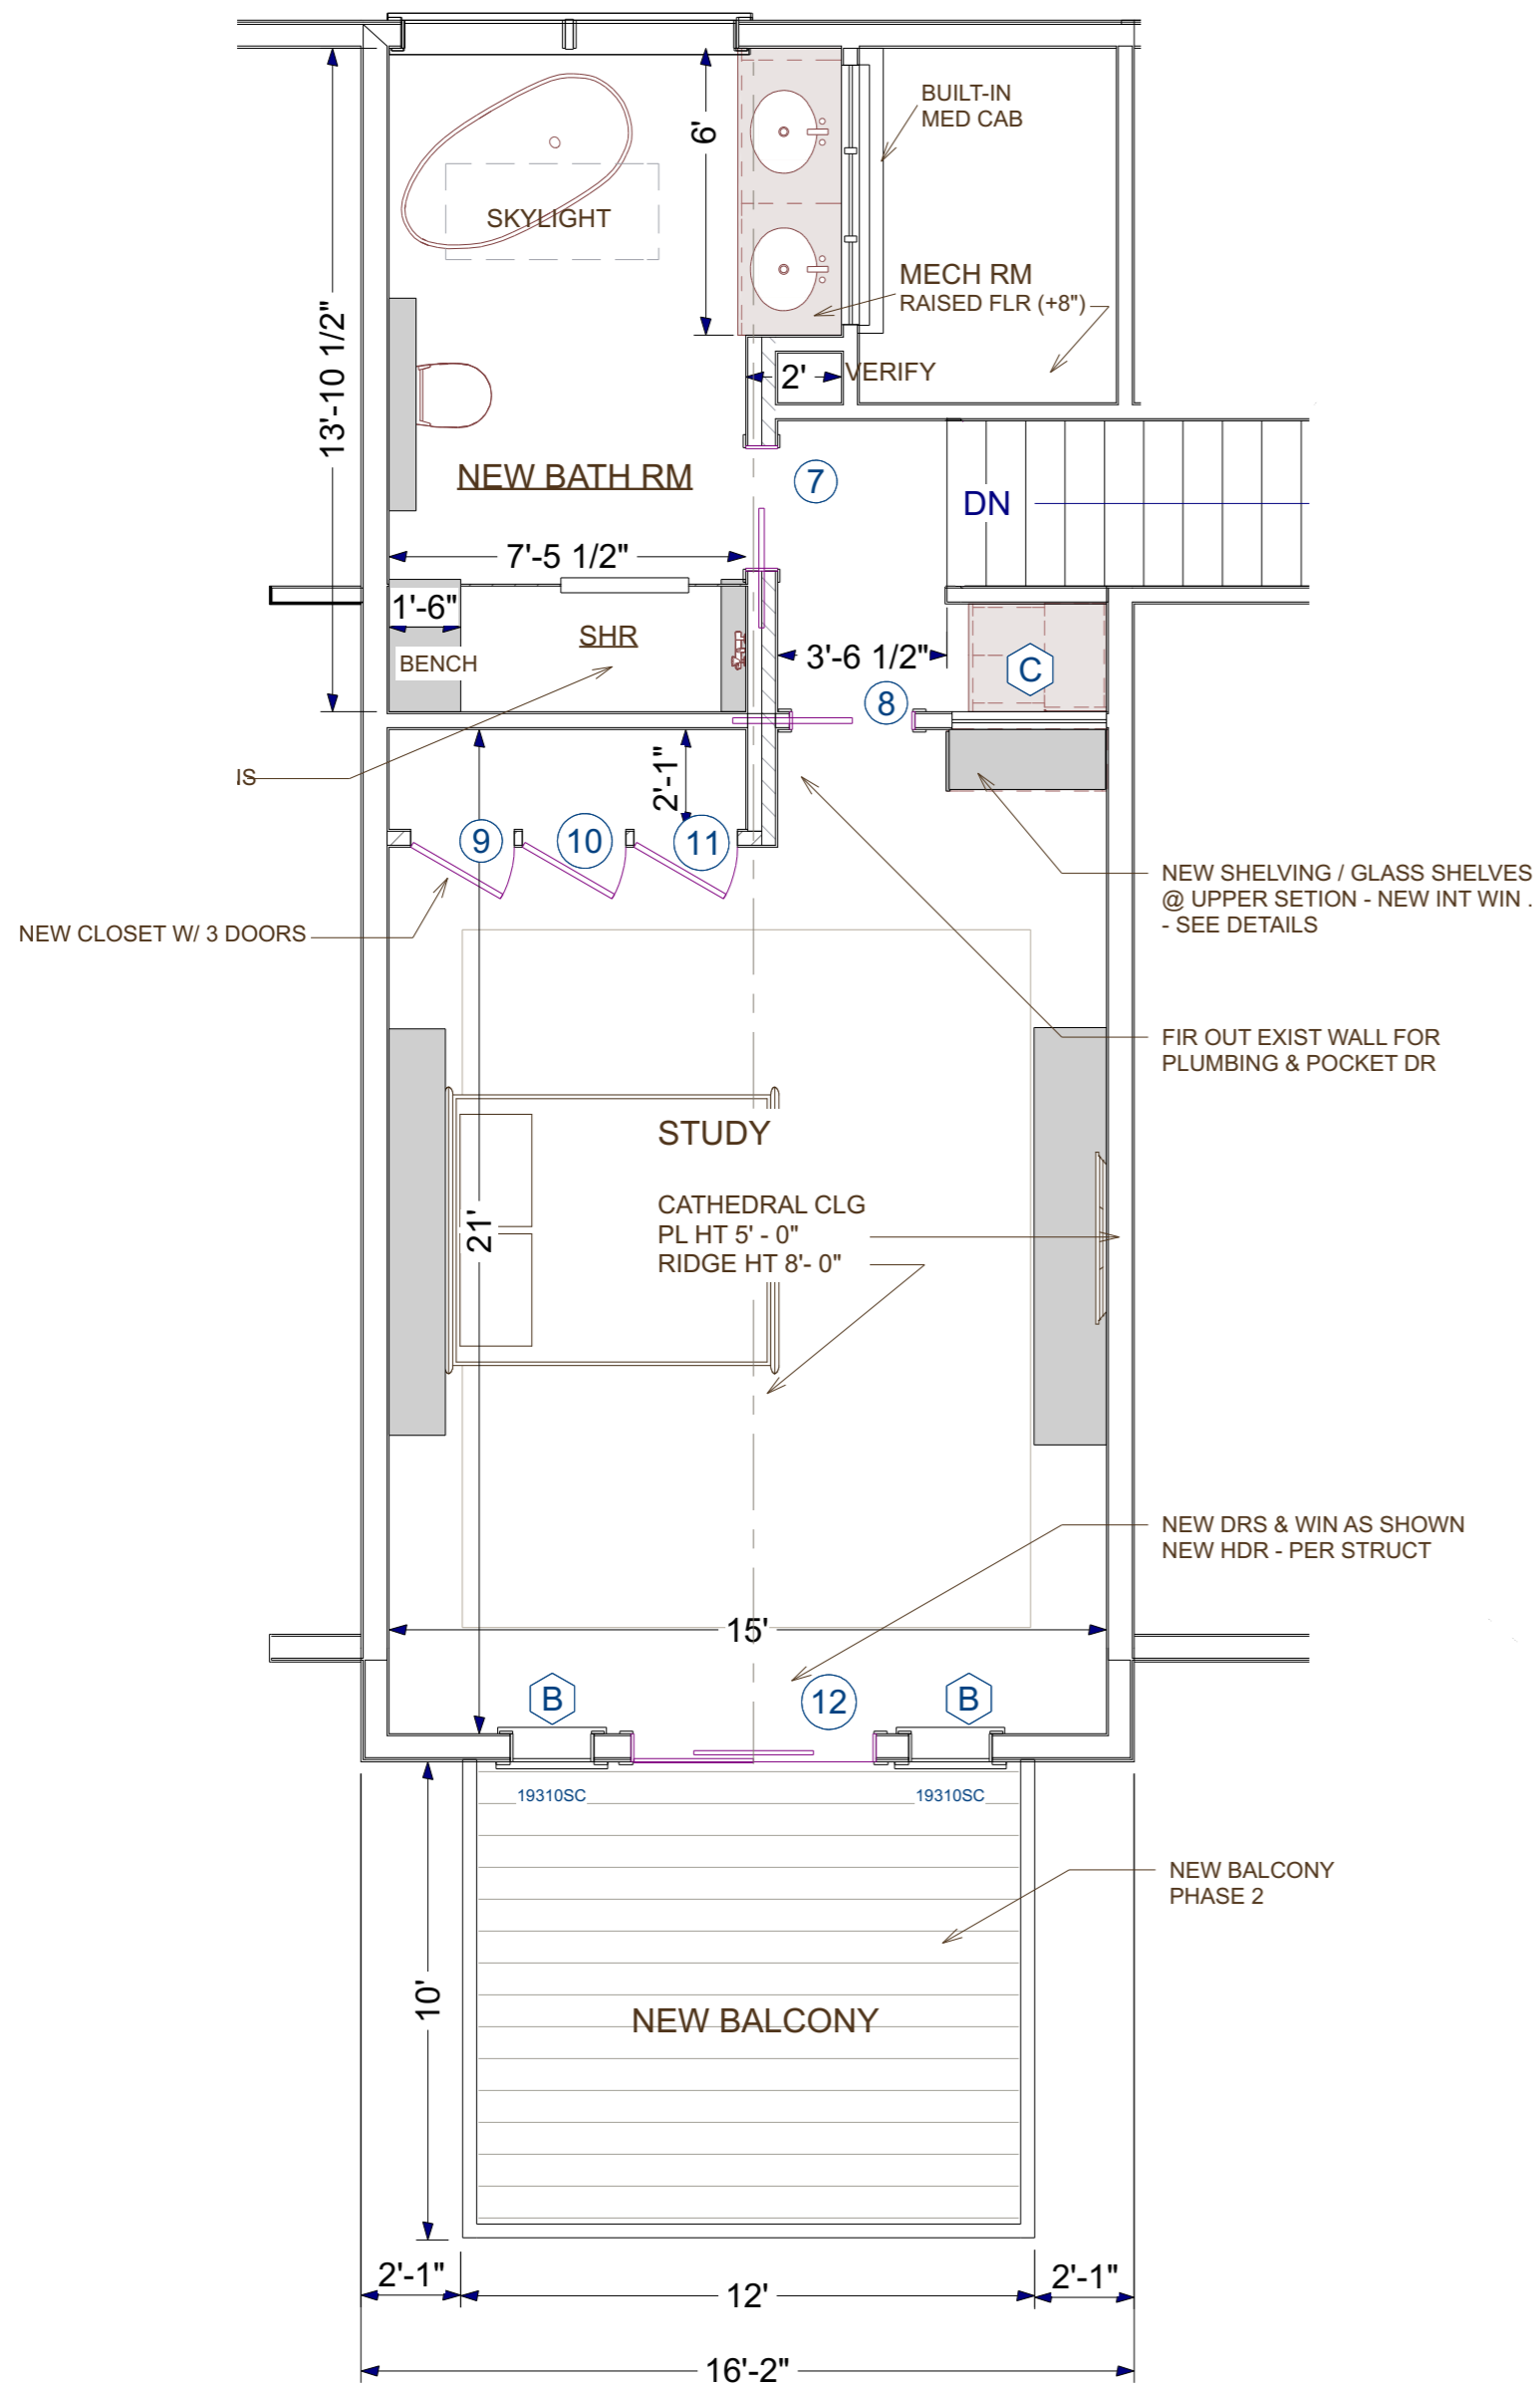


3
A-6 REMODEL - UPPER LEVEL STUDIO - FLOOR PLAN
SCALE 1/4"=1'-0" V.D.I.F.




2
A-6 REMODEL - UPPER LEVEL STUDIO
RENDER VIEWS

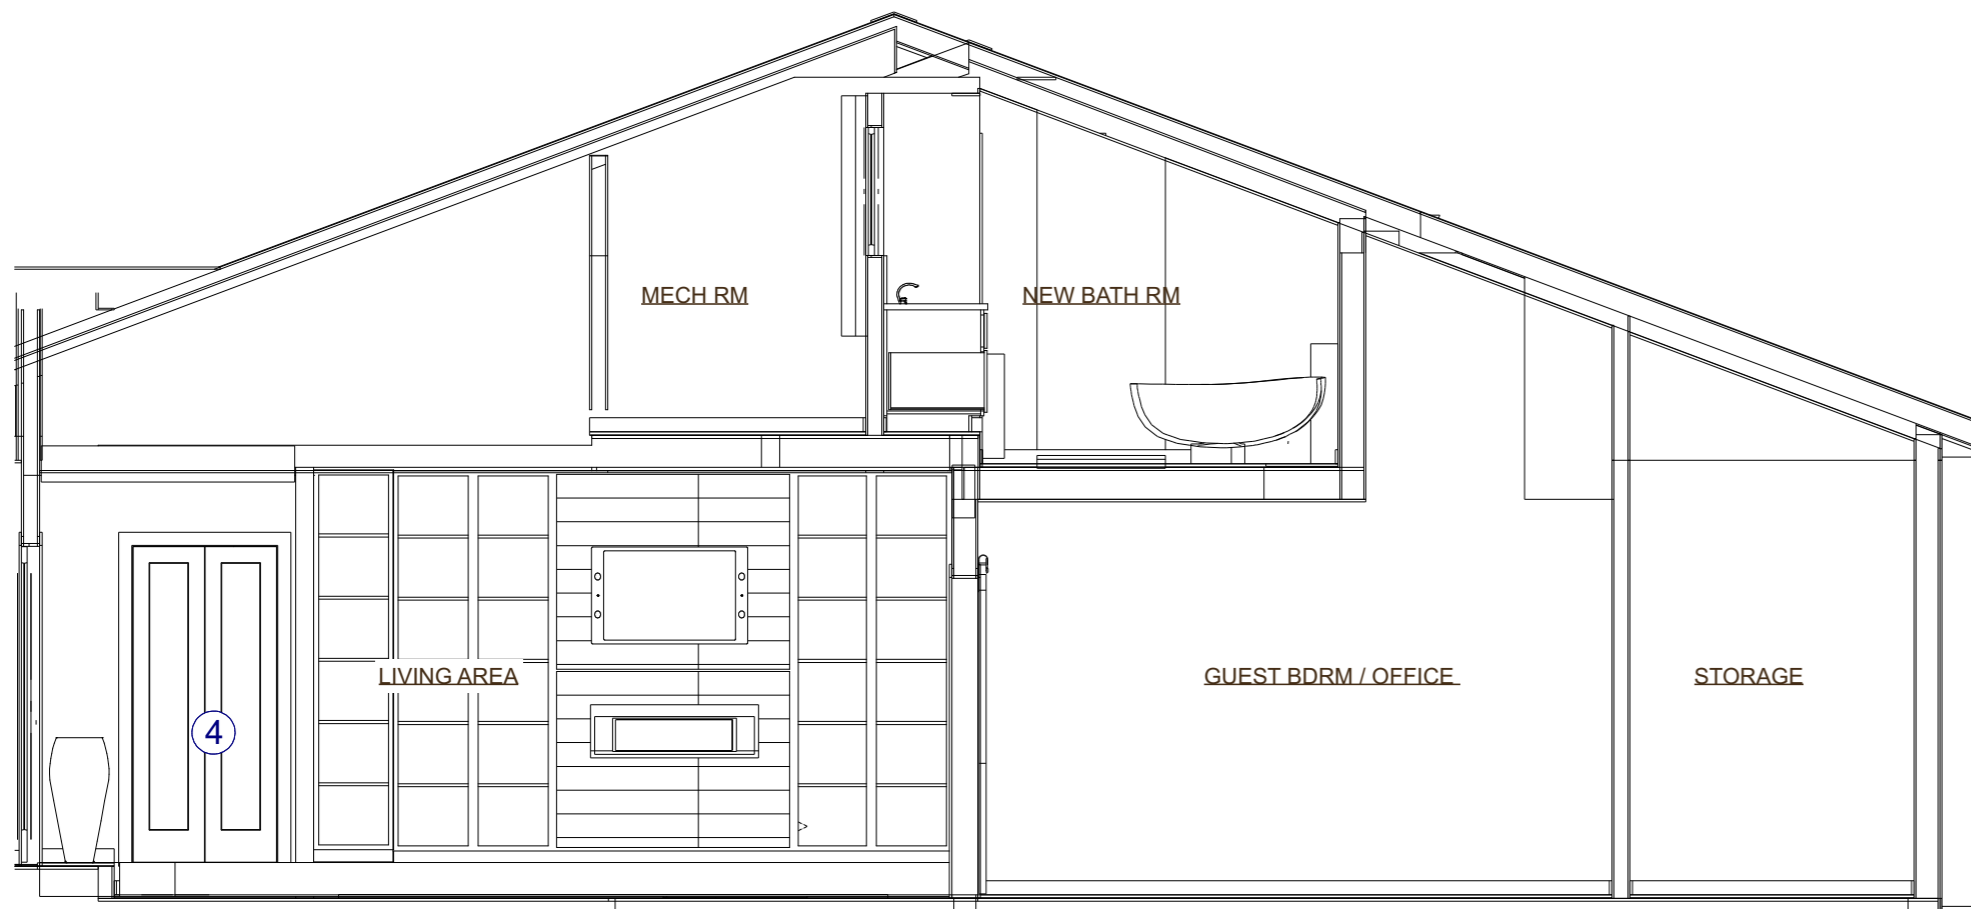

1 REMODEL - SECTION STUDIO
 A-7 1/4" = 1'-0" VDIF

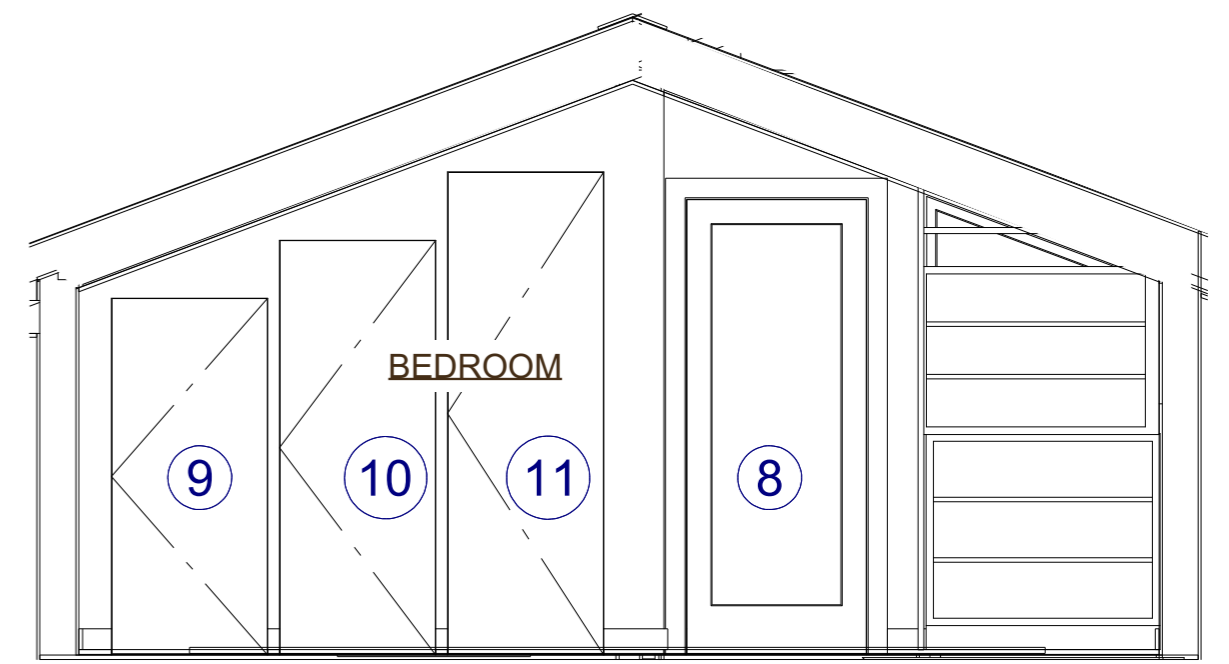

3 REMODEL - SECTION STUDIO
 A-7 3/8" = 1'-0" VDIF

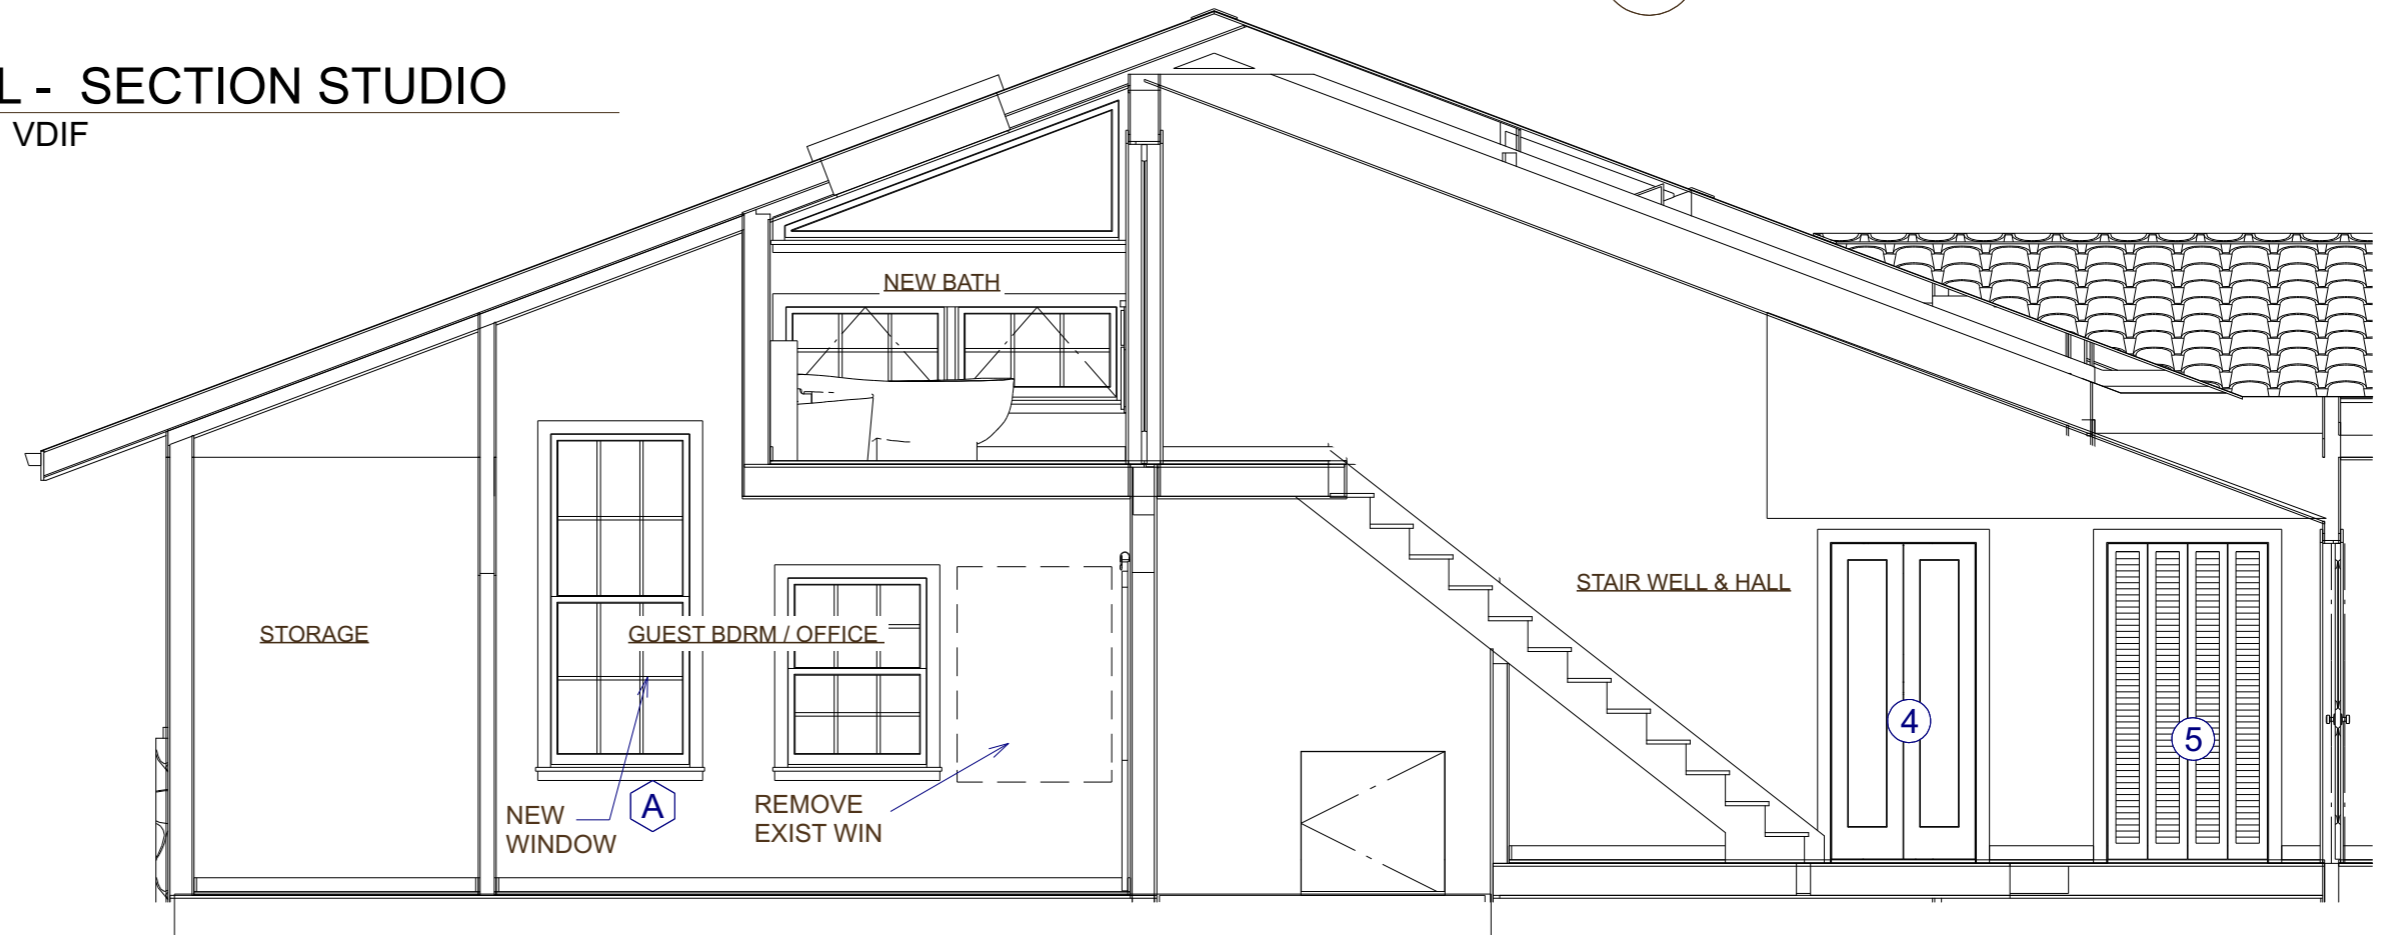



2 REMODEL - SECTION STUDIO
 A-7 1/4" = 1'-0" VDIF



2 REMODEL - EXTERIOR ELEV - SOUTH
 A-7 1/4" = 1'-0" VDIF



2 REMODEL - EXTERIOR ELEV - NORTH
 A-7 1/4" = 1'-0" VDIF

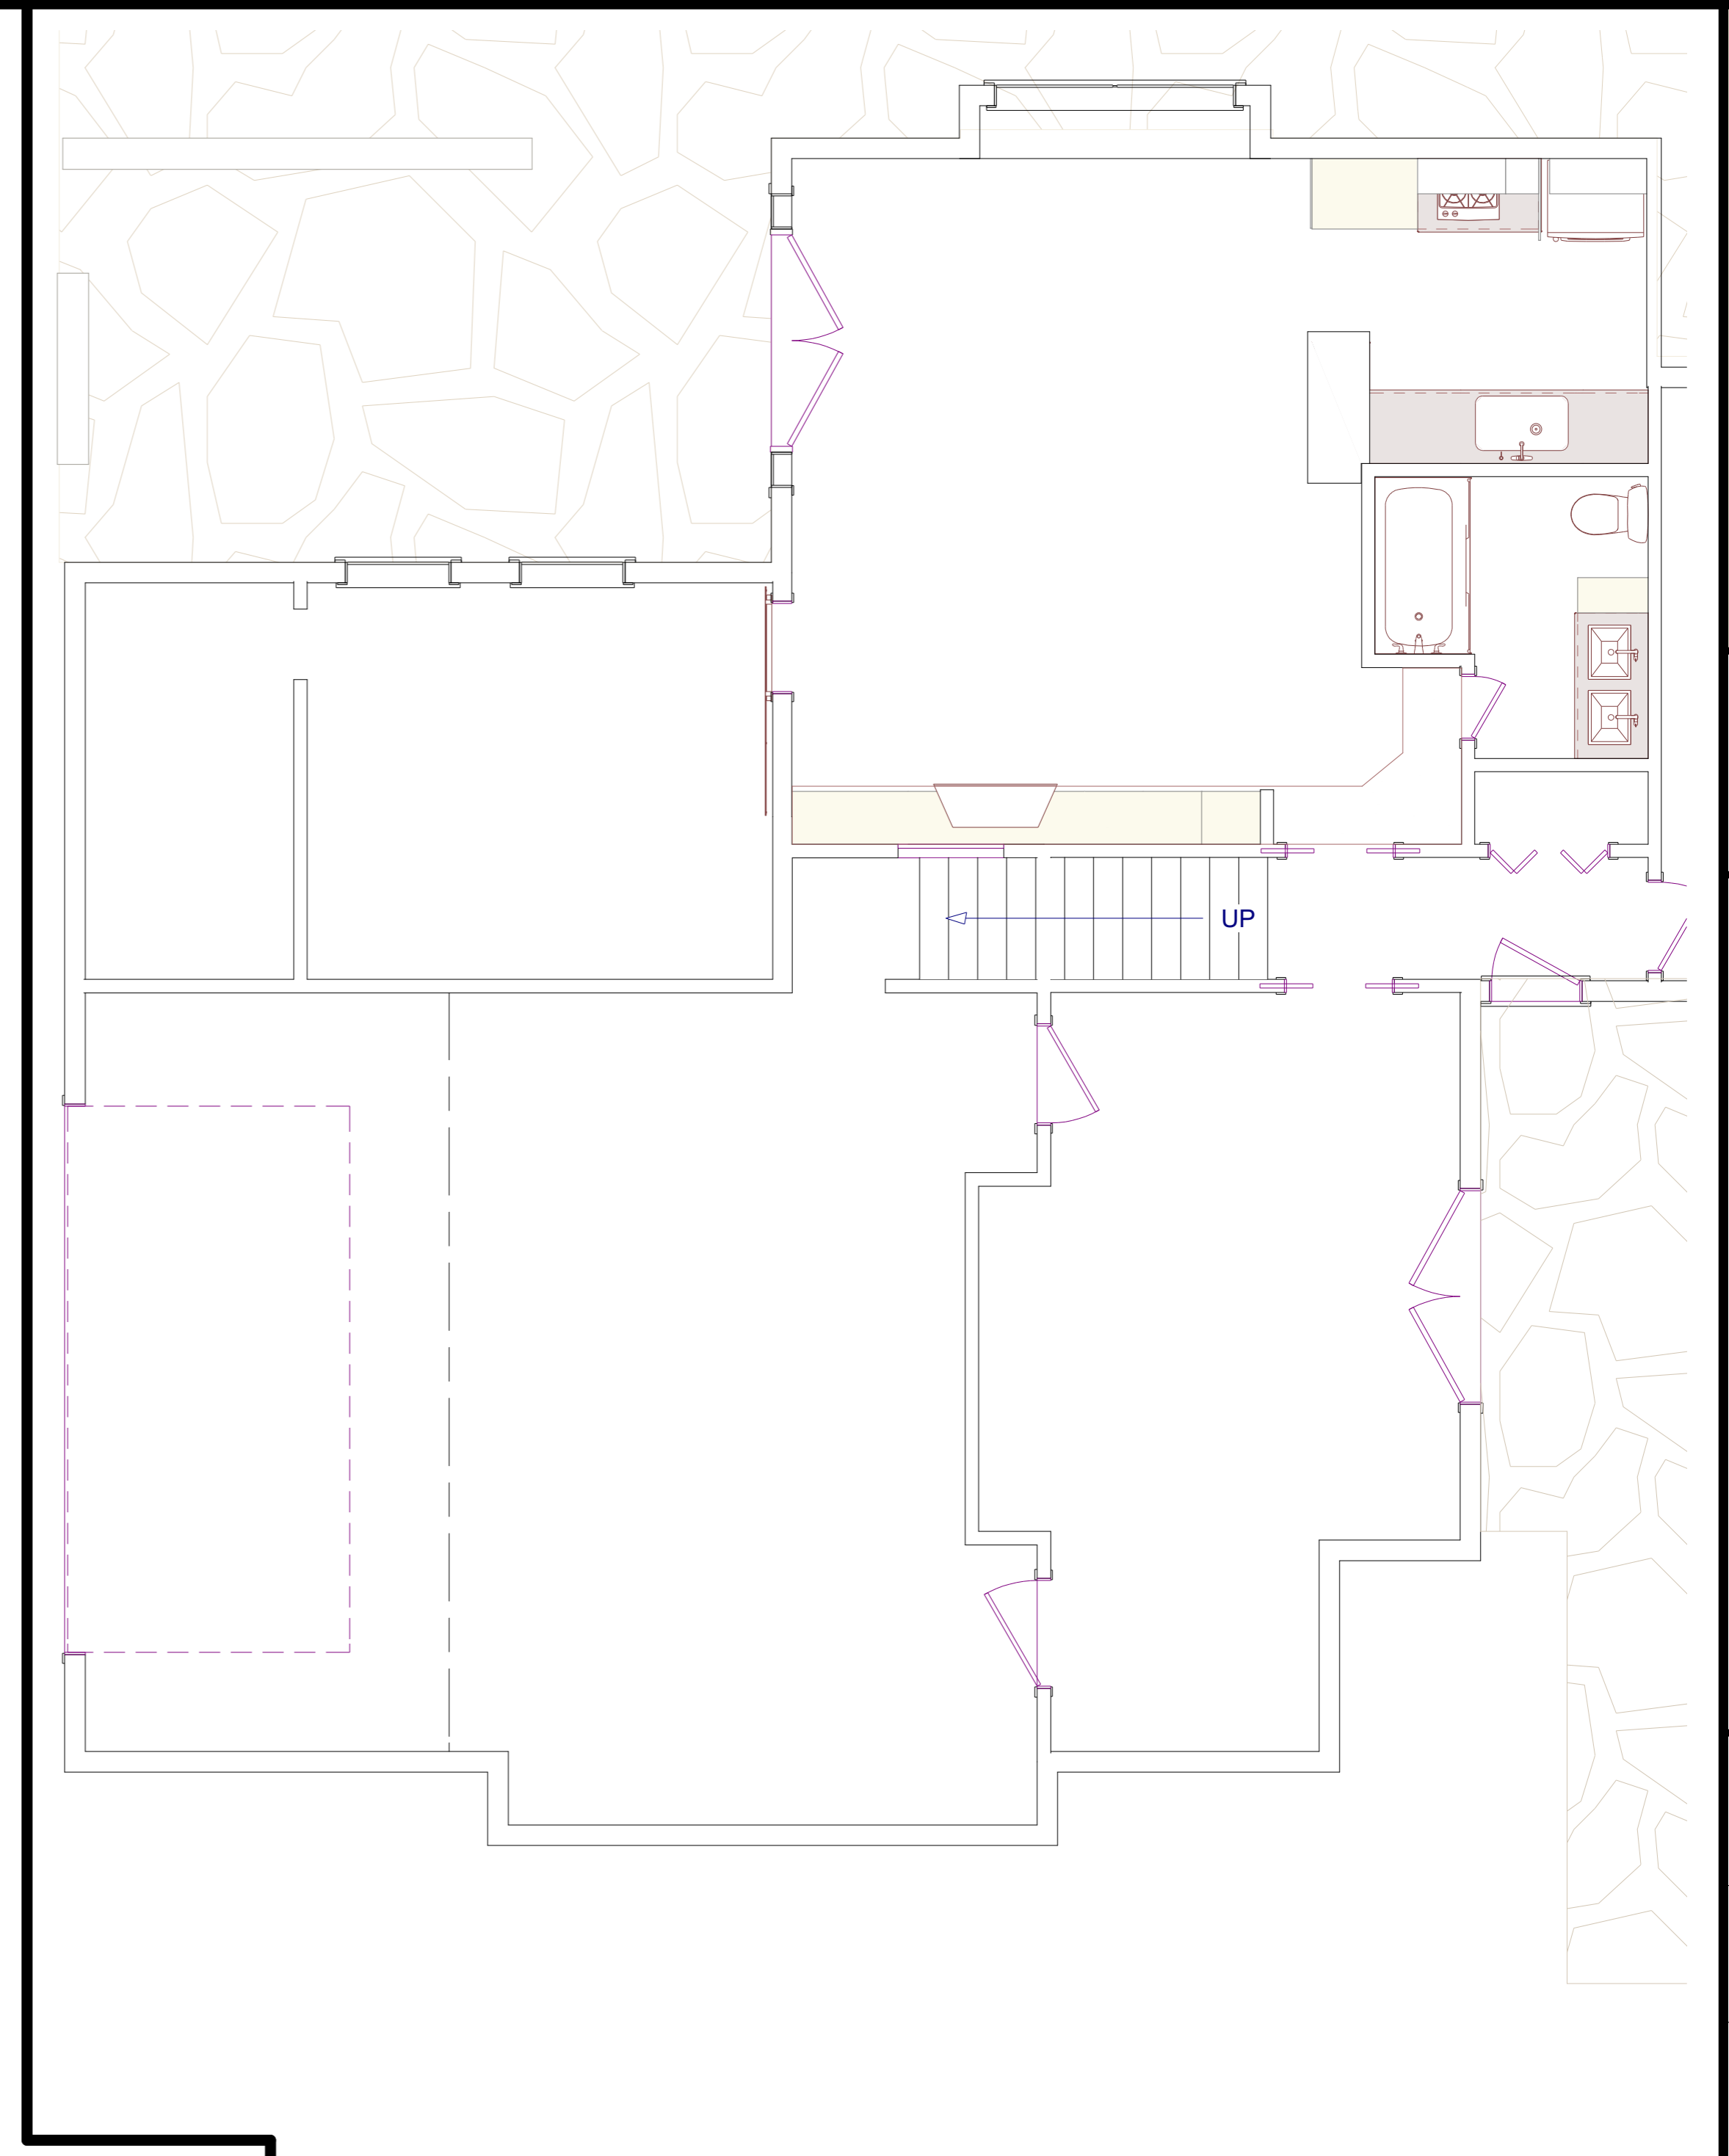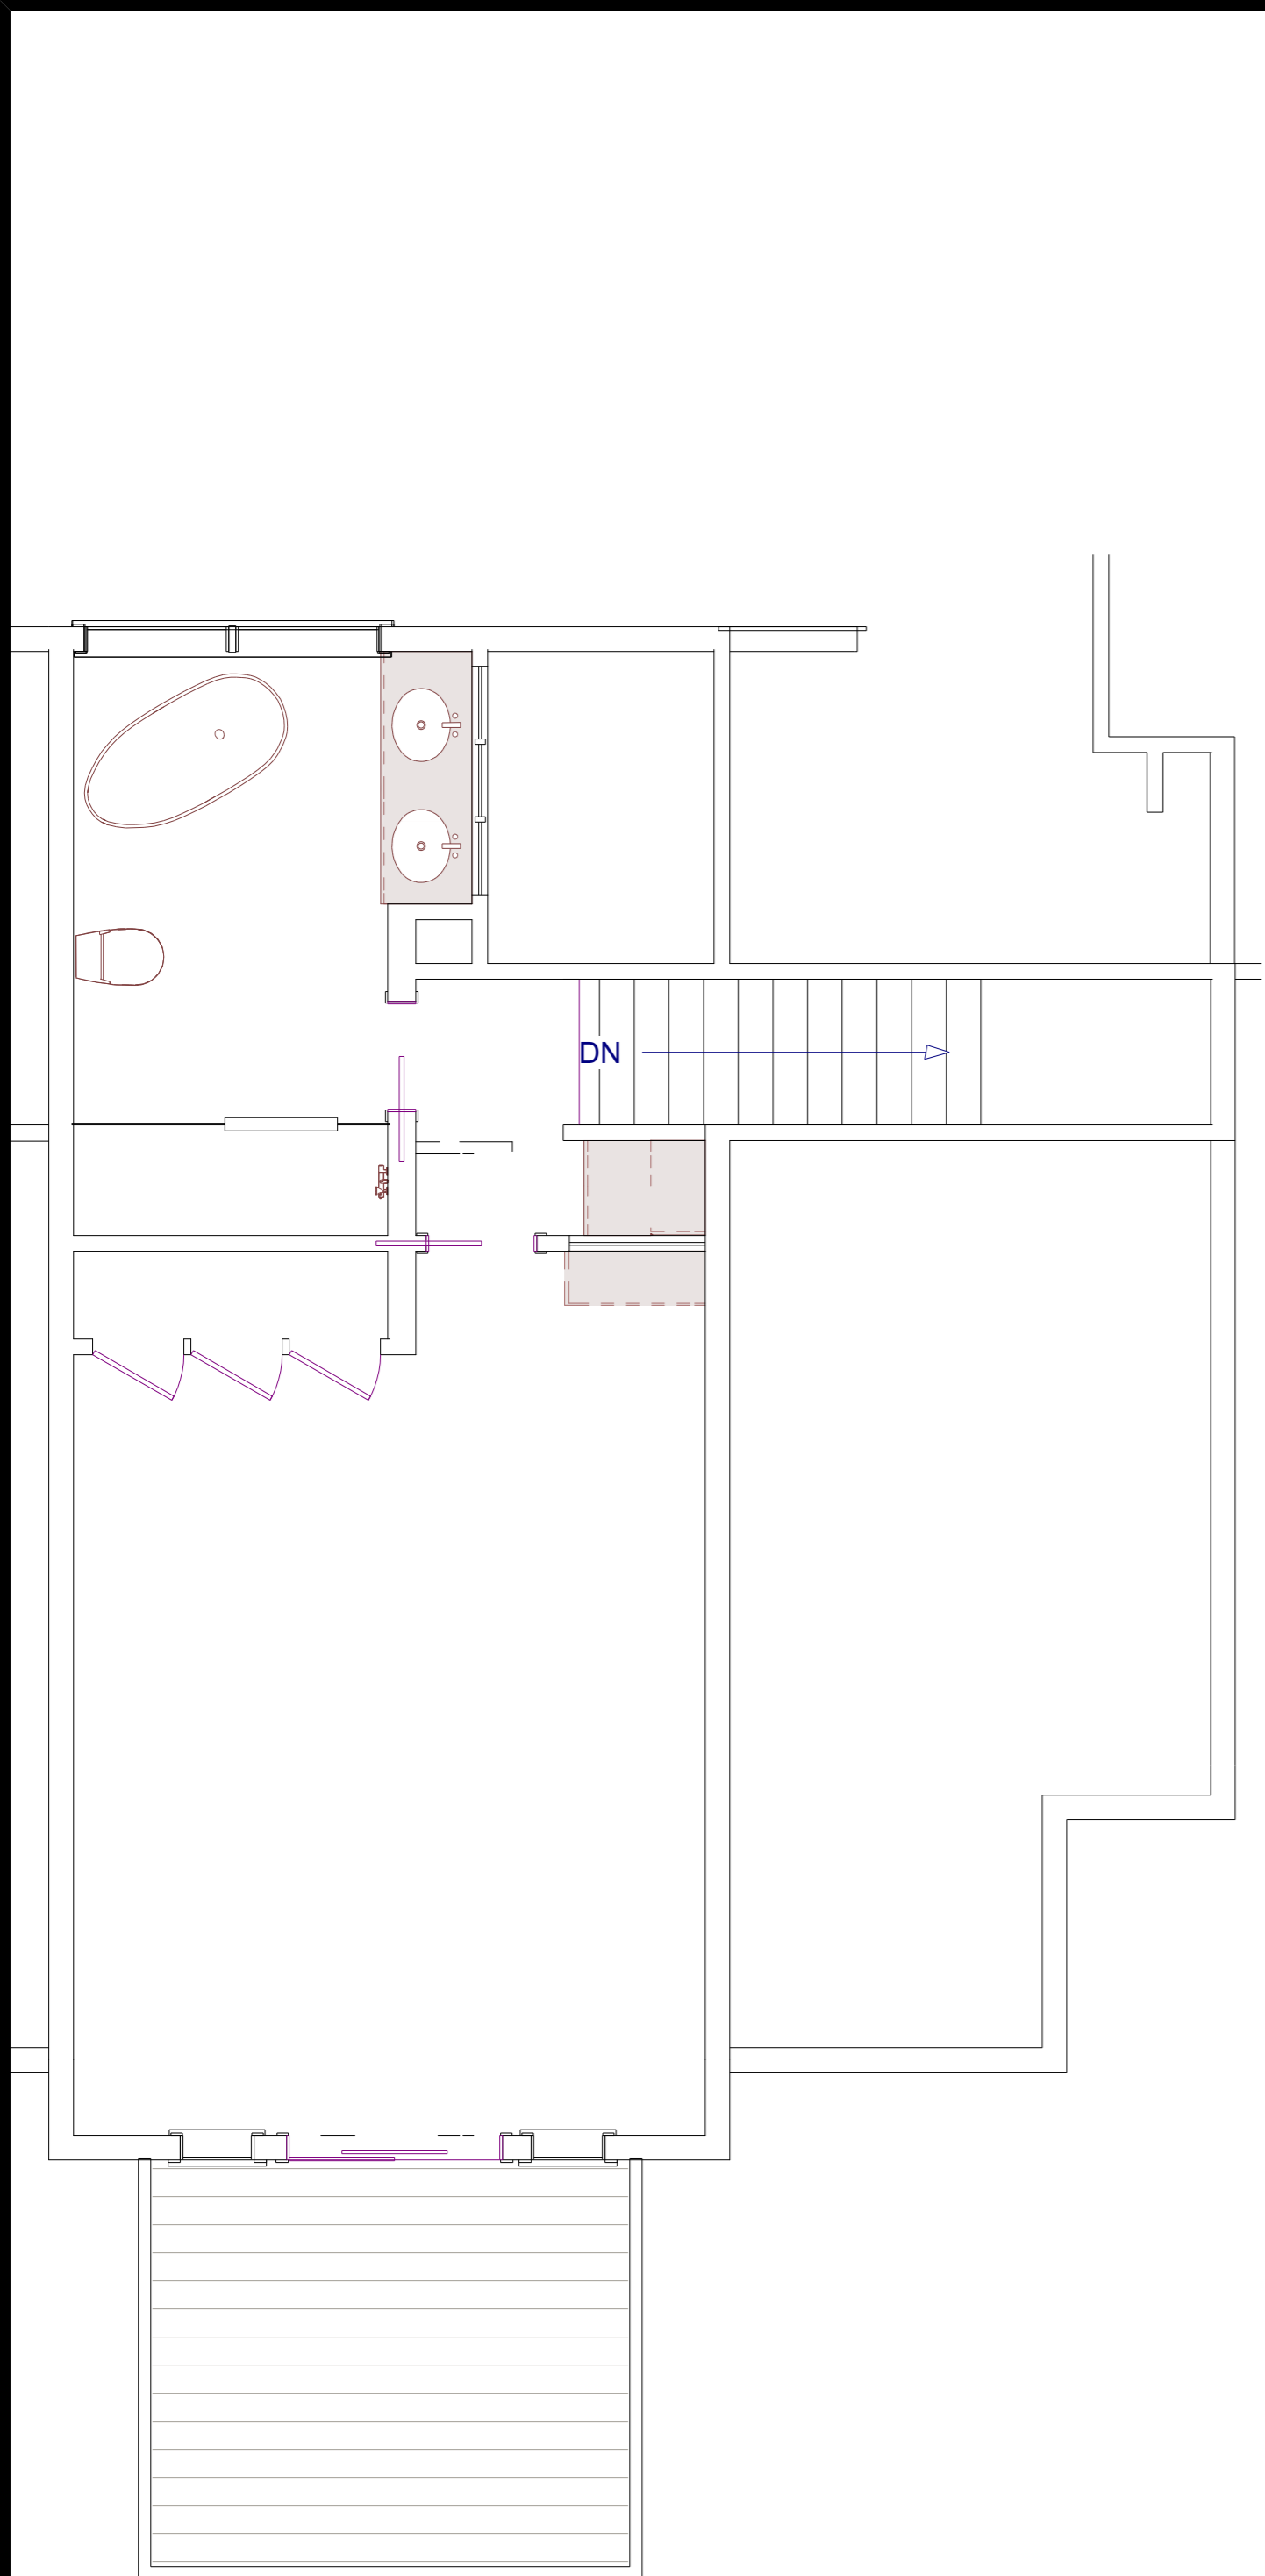

2
S-1

REMODEL STRUCTURAL PLAN - UPPER LEVEL - STUDIO

1/4" = 1'-0"

NOT FOR CONSTRUCTION

1
S-1

REMODEL STRUCTURAL PLAN - ENTRY LEVEL - STUDIO

1/4" = 1'-0"